

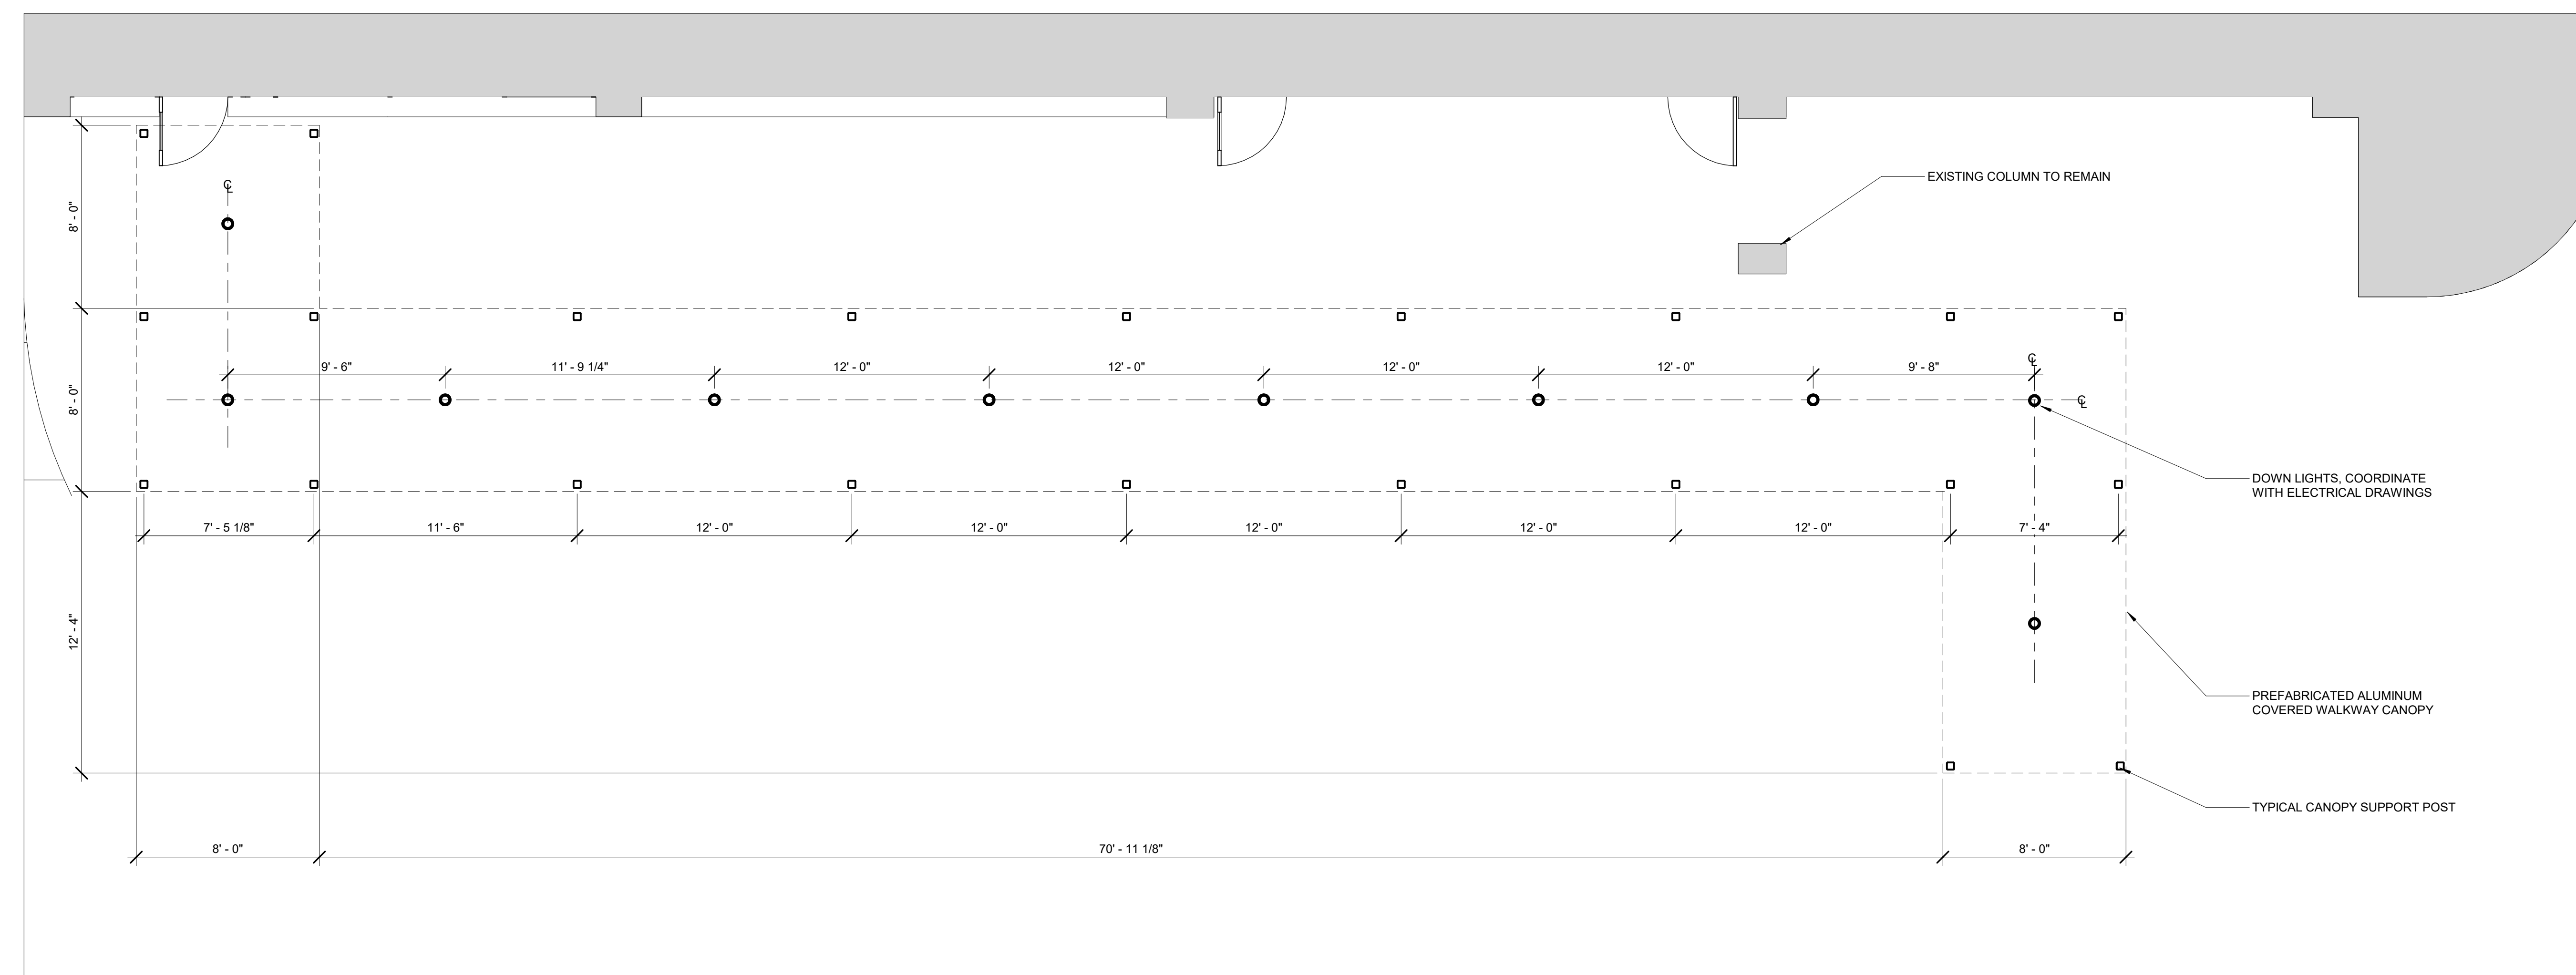
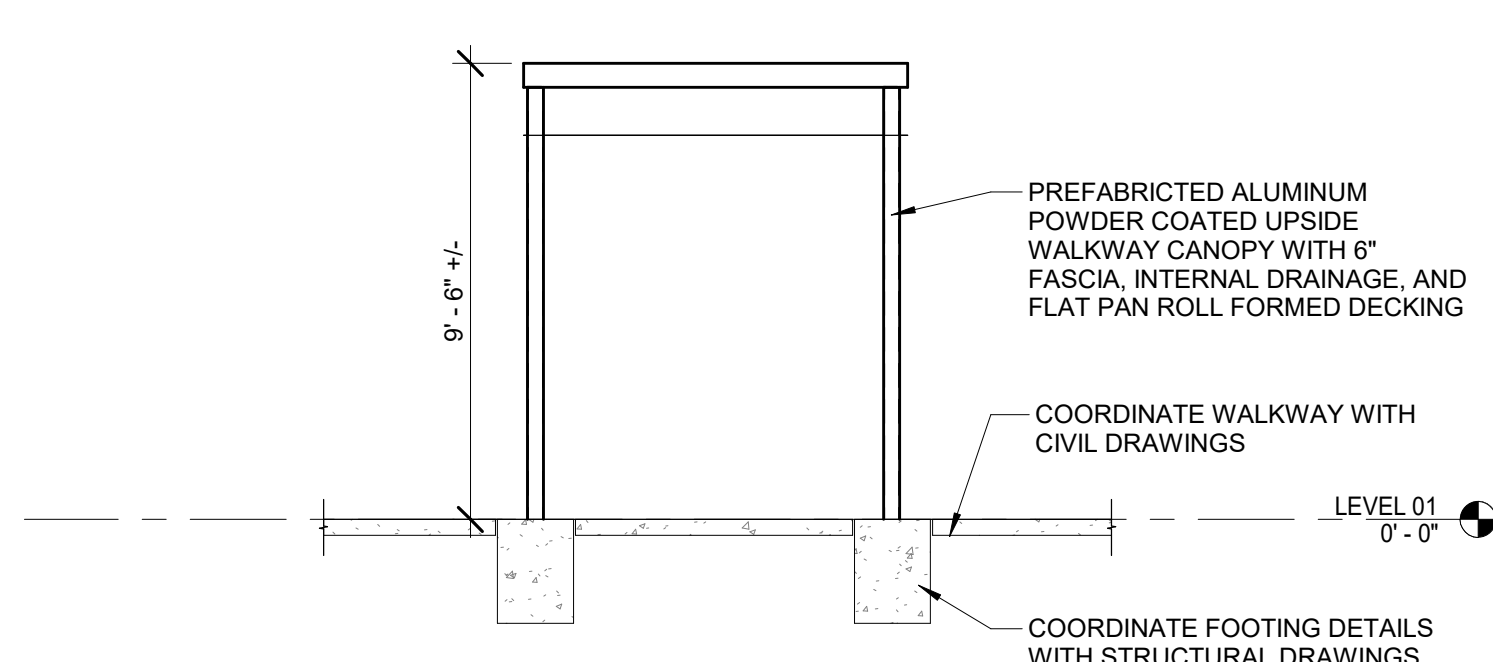


CODED NOTES - ARCHITECTURAL SITE PLAN	
NUMBER	DESCRIPTION
AS101	COORDINATE PAVING DETAILS, DIMENSIONS, AND GRADING WITH CIVIL DRAWINGS.


**vocon.**  
 cleveland.  
 3142 Prospect Avenue  
 Cleveland, OH 44115  
 new york.  
 530 5th Avenue, 16th Floor  
 New York City, NY 10036  
 vocon partners llc

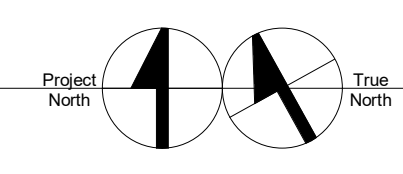


**B ENLARGED CANOPY PLAN**  
 SCALE: 1/4" = 1'-0"

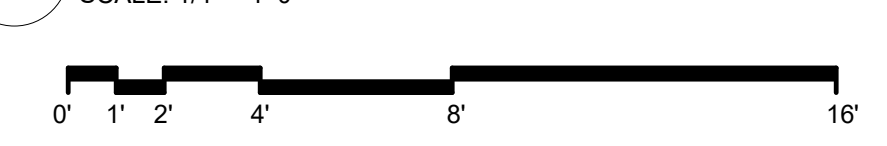

**1 TYPICAL CANOPY SECTION**  
 SCALE: 1/4" = 1'-0"

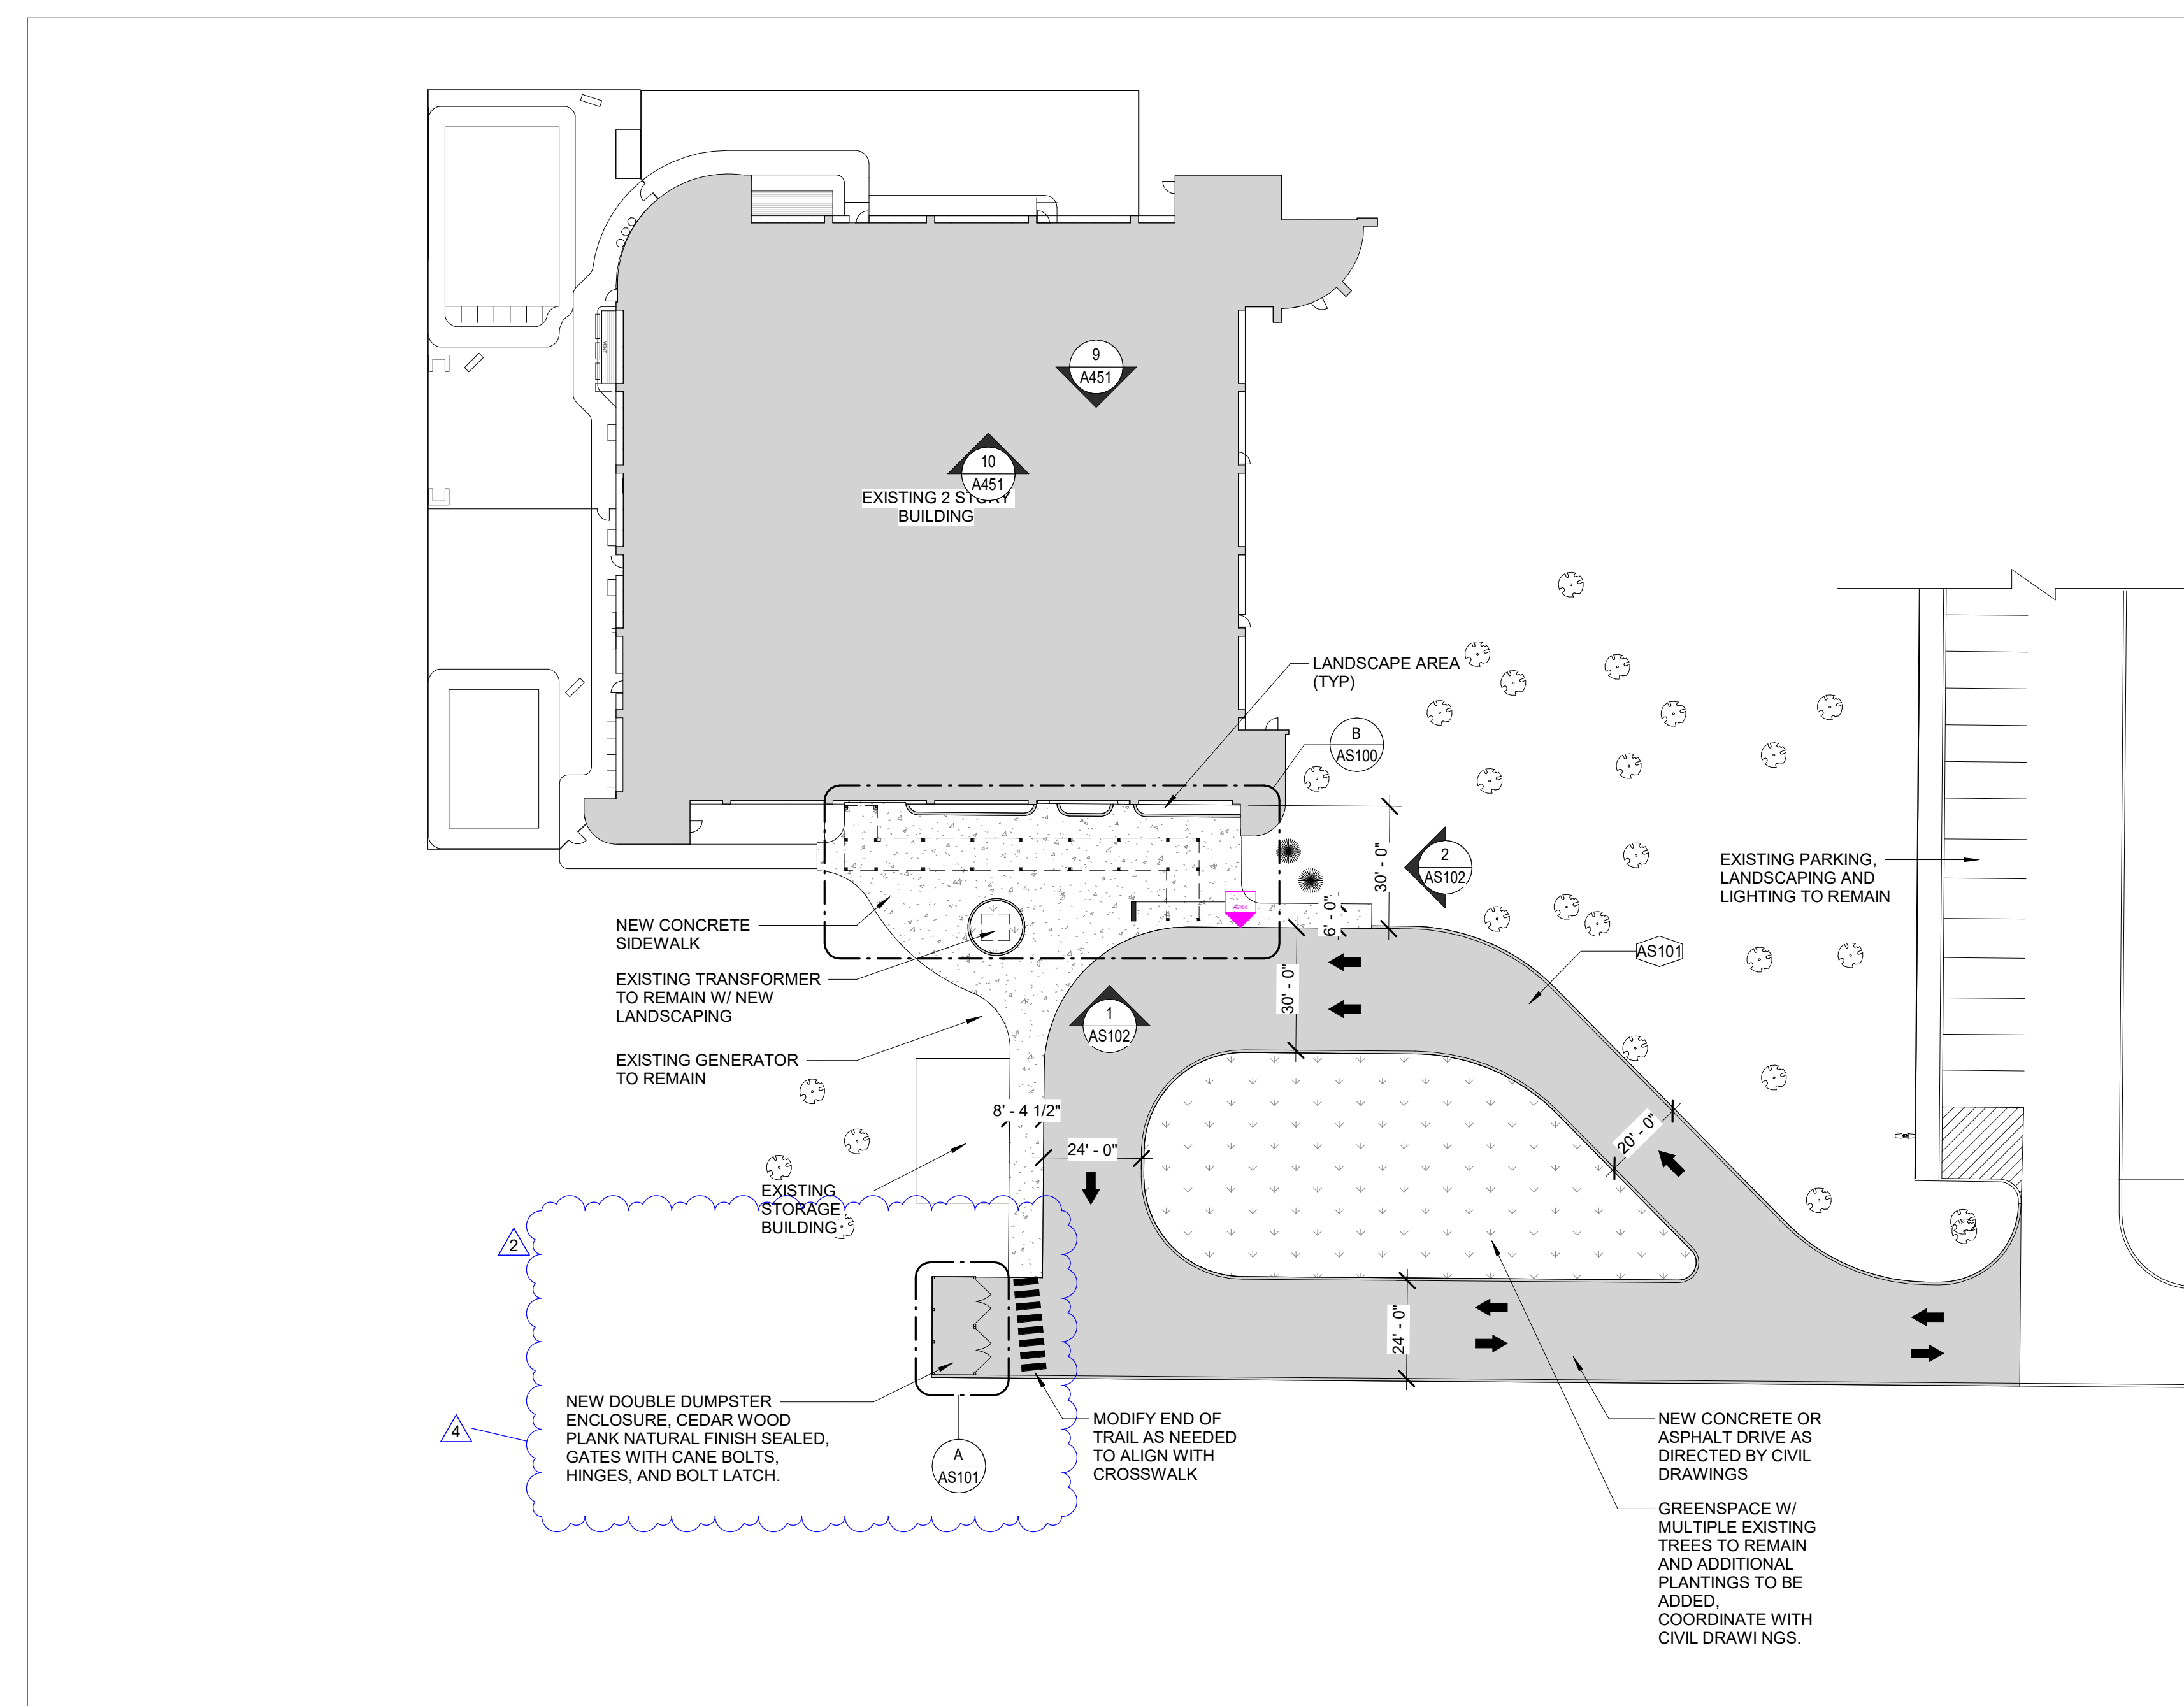

**A ARCHITECTURAL SITE PLAN**  
 SCALE: 1" = 30'-0"

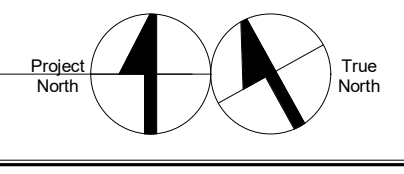

I hereby certify that this drawing, specification, plan or report was prepared by me or under my direct supervision and that I am a duly registered Architect under the laws of the state which govern this project. No person may alter these documents without my written consent or the supervision of the licensed record Architect, (including copyrights).

PROFESSIONAL SEAL OF JOHN C. WORKLEY  
 REGISTERED ARCHITECT  
 10157  
 Date: 07/08/2025  
 John C Workley Registration Number: 10157  
 Expiration Date: 12/30/25

PROPOSED TENANT IMPROVEMENTS FOR:

**Achievement Centers for Children**

28501 Clemens Rd.  
 Westlake, OH 44145

JOB NUMBER: 240302.01

DRAWING RELEASE:

Rev.	Date	Description
	07/08/2025	BID/PERMIT
	08/06/2025	Planning Commission
1	08/14/2025	PLAN REVIEW
2	08/15/2025	BULLETIN 1
4	1/5/2026	Planning Commission

GENERAL REFERENCE AND COORDINATION NOTES

- REFER TO THE SPECIFIC TRADE DRAWINGS FOR COORDINATION OF DEMOLITION, CONSTRUCTION, AND INFORMATION NOT SHOWN ON THIS PLAN FOR MECHANICAL, ELECTRICAL, PLUMBING, STRUCTURAL, CIVIL, AND FIRE PROTECTION WORK.
- REFER TO THE ARCHITECTURAL FLOOR PLANS FOR COORDINATION OF DEMOLITION, CONSTRUCTION, AND INFORMATION NOT SHOWN ON THIS PLAN. I.E. WALL TYPES & DETAILS FOR NEW CONSTRUCTION.
- REFER TO GENERAL NOTE SHEETS FOR STANDARDS. A. SHEET G100 SERIES FOR CODE AND LIFE SAFETY PLAN INFORMATION AND COORDINATION ITEMS.
- SHEET G200 SERIES FOR ACCESSIBILITY GUIDELINES, DRAWING STANDARDS, GENERAL NOTES FOR ALL PHASES OF CONSTRUCTION, LEGENDS, MATERIALS, ABBREVIATIONS & SYMBOLS.

SHEET TITLE:

**ARCHITECTURAL SITE PLAN**

SHEET NUMBER:

**AS100**